


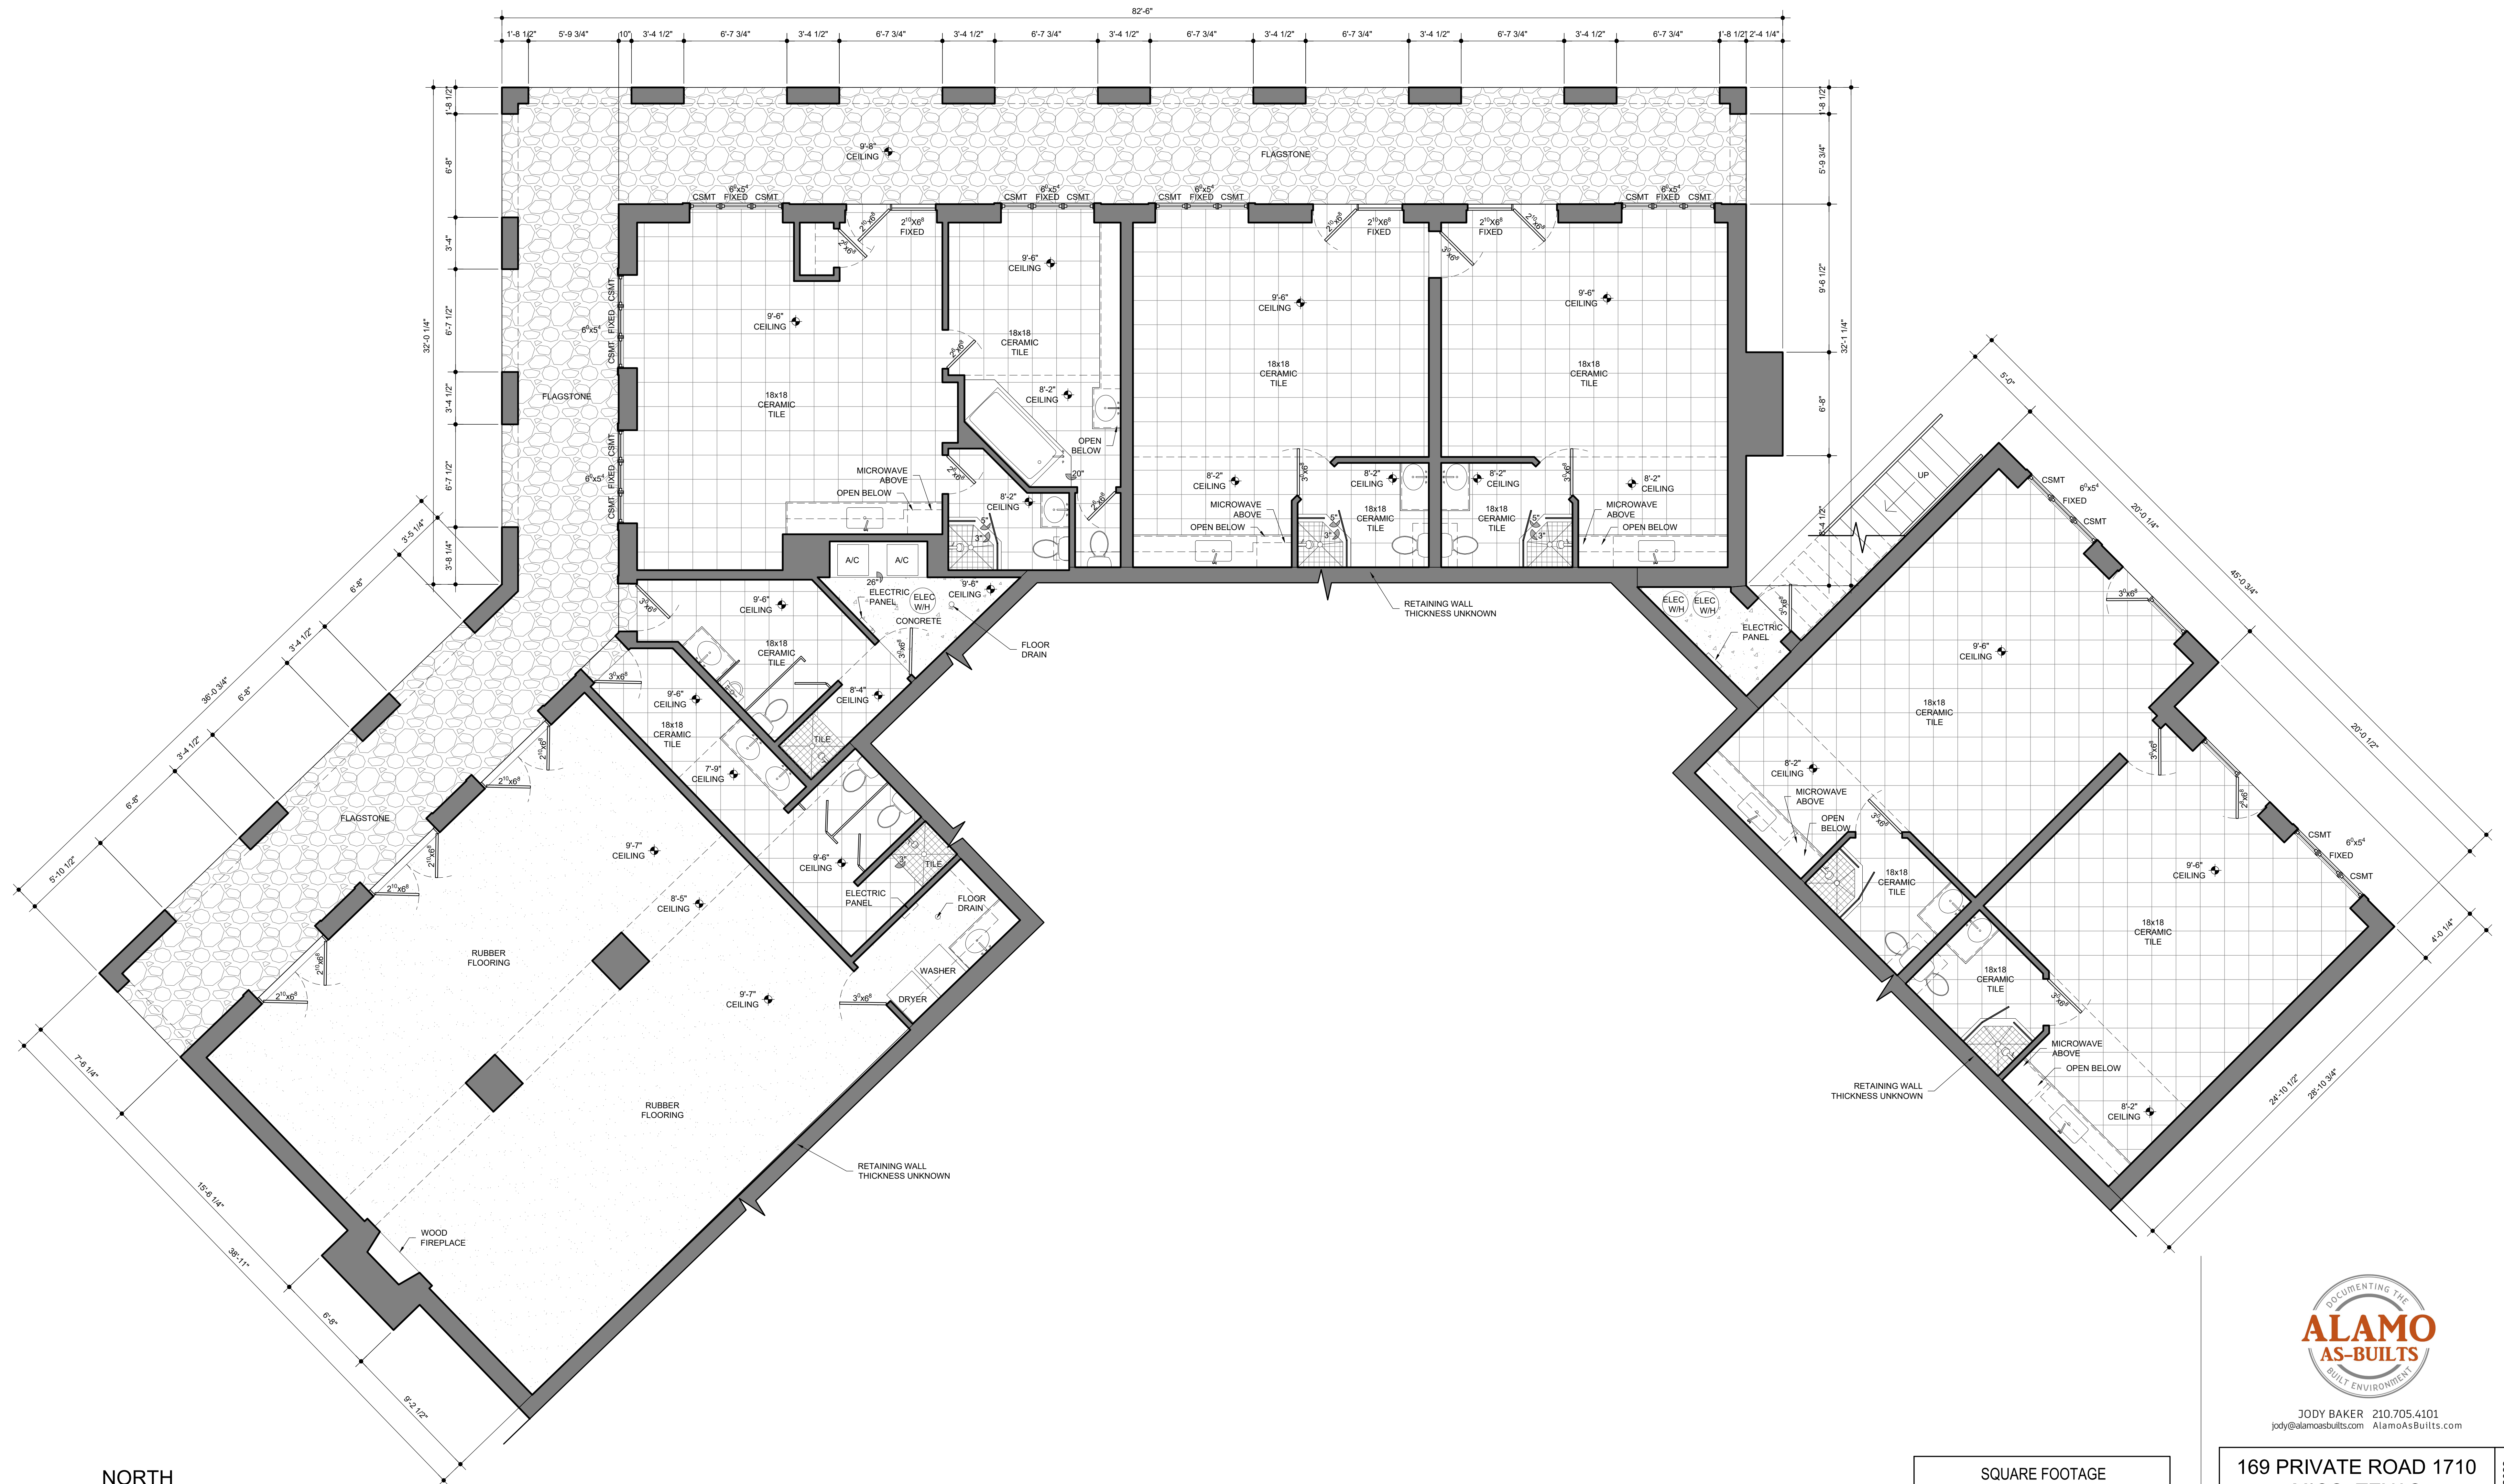

NORTH


1
A-10
1/4" = 1'-0"

LOWER FLOOR PLAN


SQUARE FOOTAGE			
LOWER LEVEL			
CONDITIONED	4,348		SF
UNCONDITIONED			
PORCH	1,003		SF
WATER HEATER CLOSET	37		SF
MAIN LEVEL			
CONDITIONED			
BANQUET HALLS	3,355		SF
OFFICE/KITCHEN	1,125		SF
UNCONDITIONED			
FRONT PORCH	849		SF
REAR PORCH	1,128		SF
CUPOLA			
UNCONDITIONED	253		SF
TOTAL OF ALL SPACES	12,188		SF

AS-BUILTS

Sheet Number
A-10

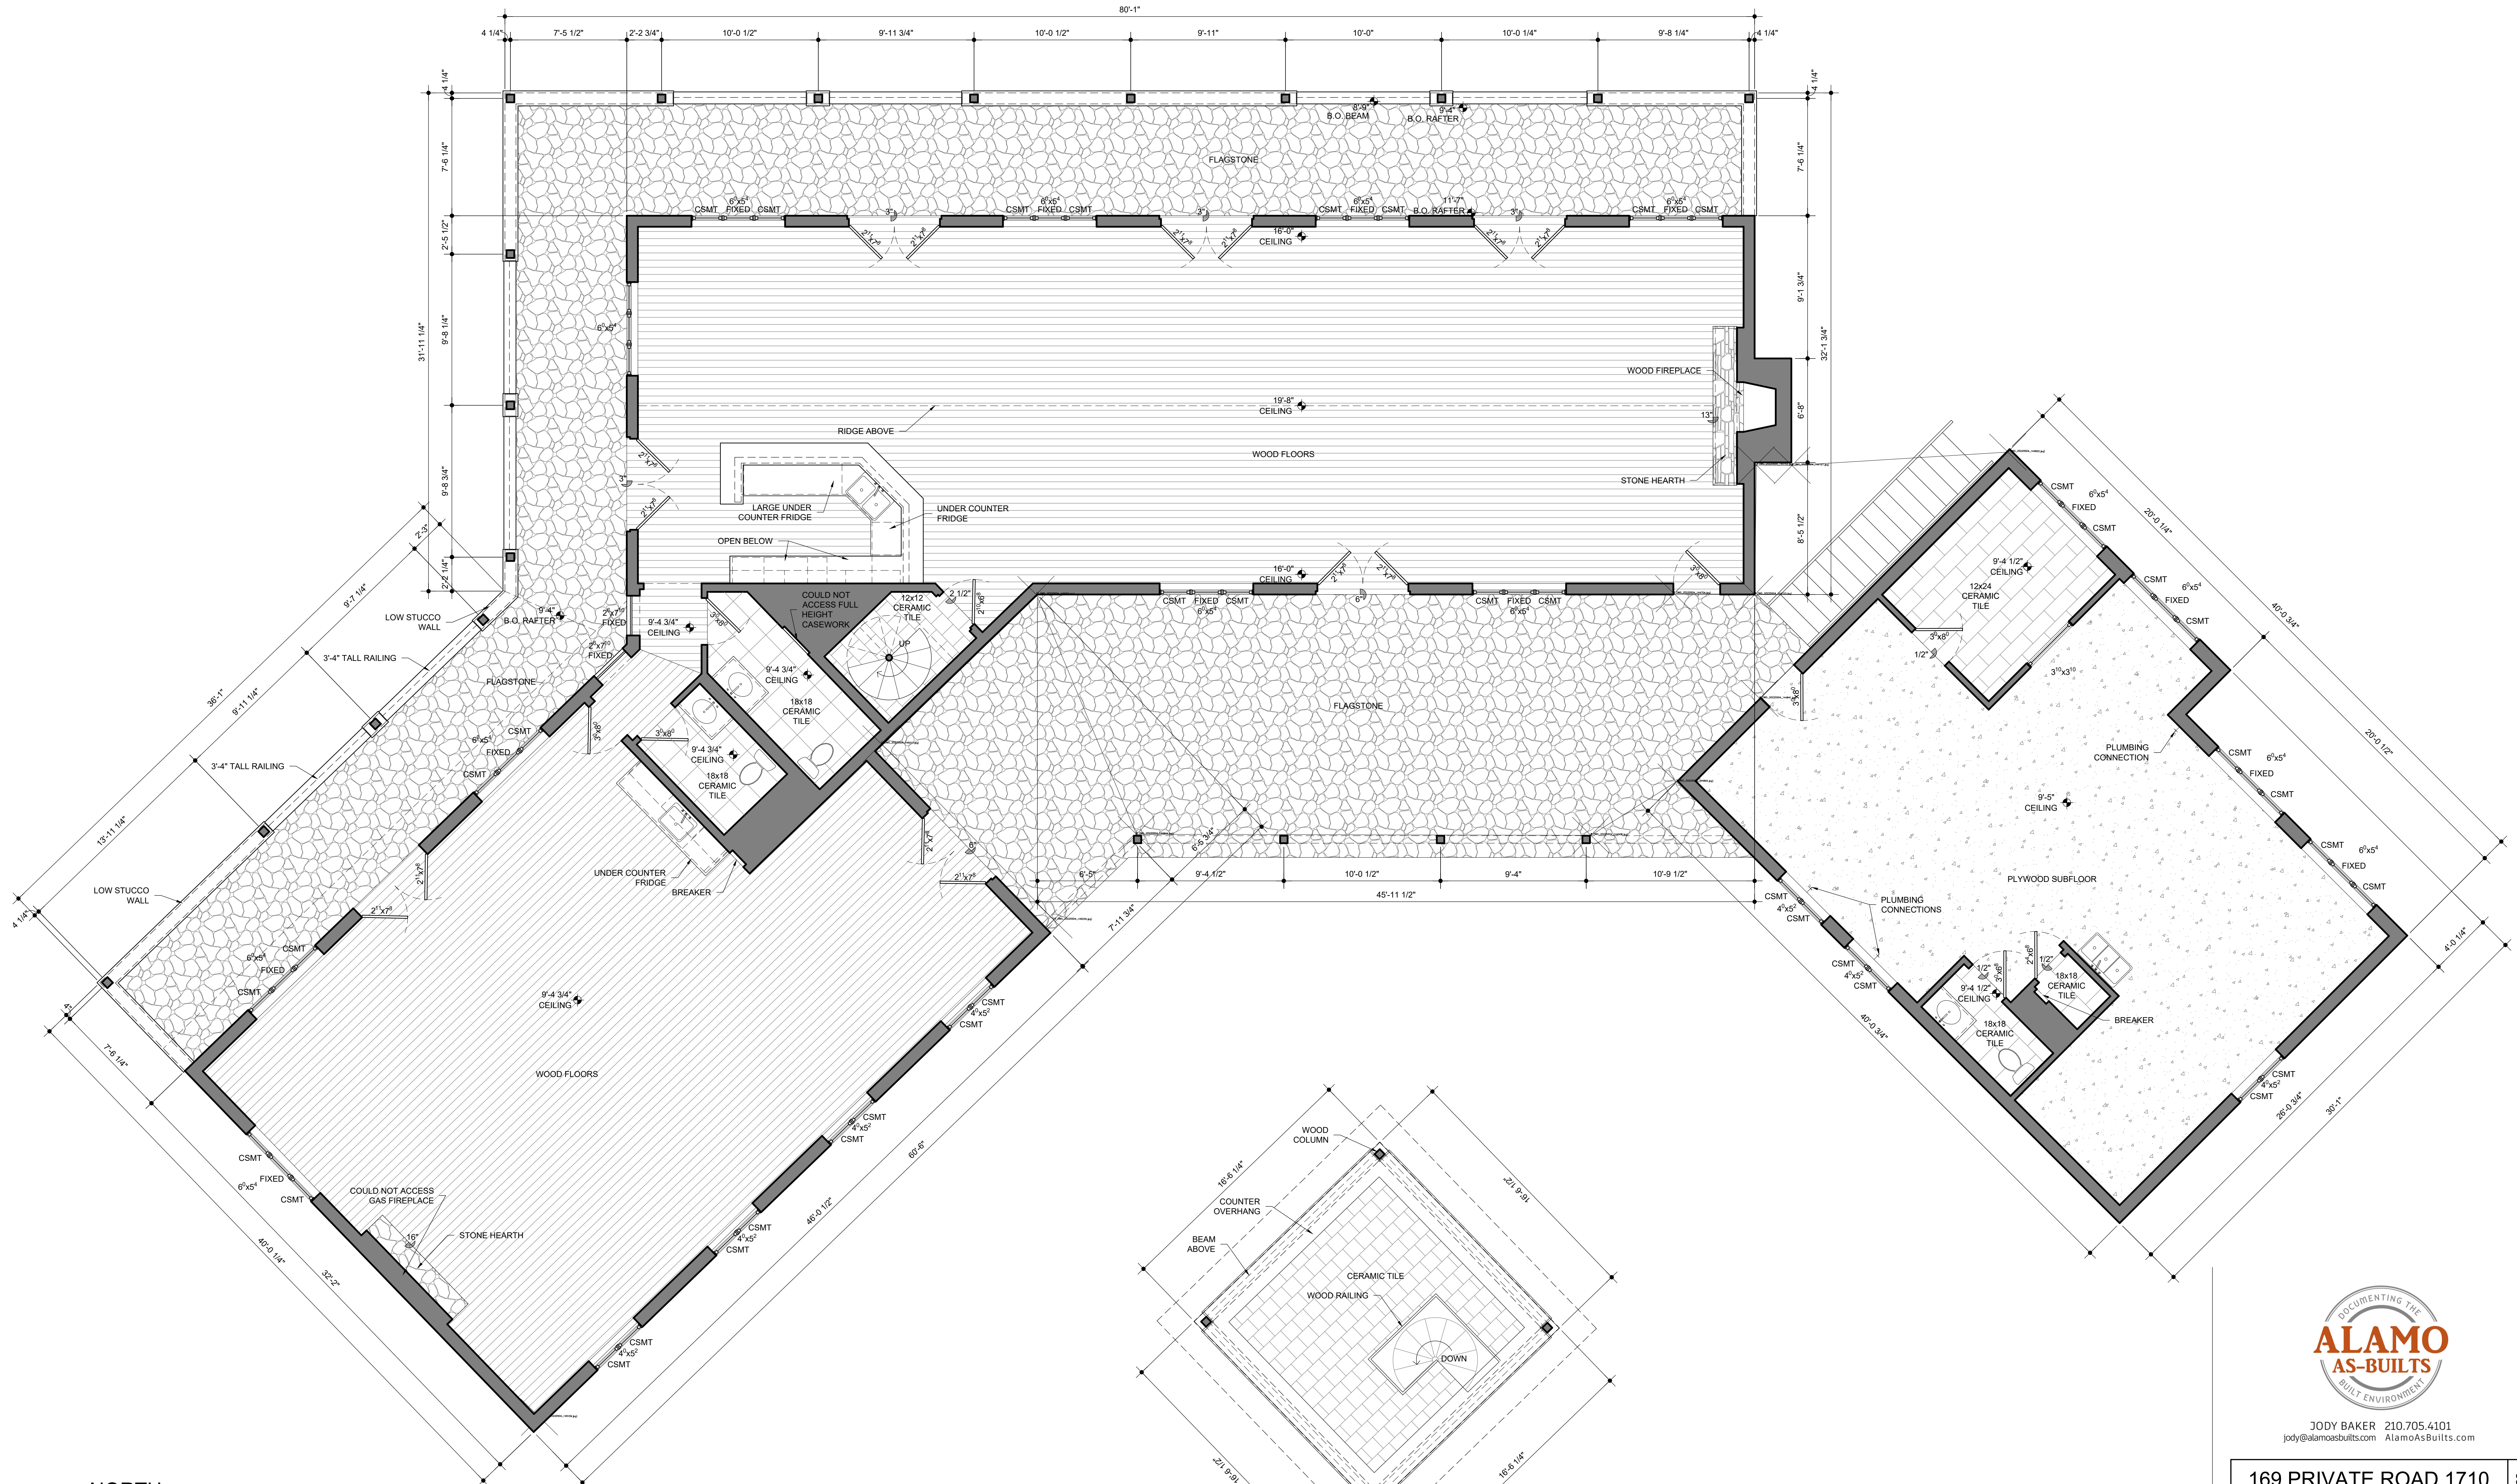

NORTH

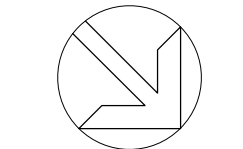

1 MAIN FLOOR PLAN
1/4"=1'-0"

2 CUPOLA FLOOR PLAN
1/4"=1'-0"



JODY BAKER 210.705.4101
jody@alamoasbuilds.com AlamoAsBuilds.com

169 PRIVATE ROAD 1710
MICO, TEXAS

MAIN FLOOR AND
CUPOLA FLOOR PLAN

Sheet Number

AS-BUILTS

A-11

169 PRIVATE ROAD 1710 - AS-BUILTS

DATE: 05.11.2022